


# Suite 901

N<sup>1</sup>

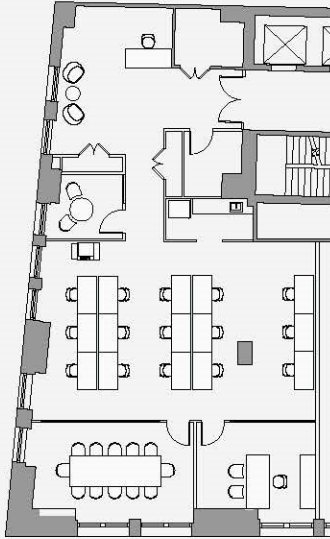


WILLIAM STREET

## AS-BUILT – TEST FIT

Private Offices	1	Conference Rooms	2
Benching	15	Café	1
Reception	1	Coat Room	1
		IT Room	1

---

**TOTAL HEADCOUNT**      **17**

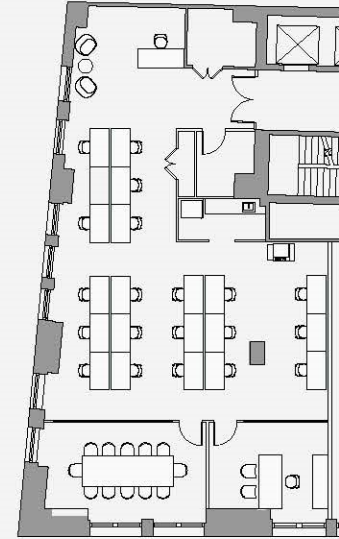

WILLIAM STREET

## PREBUILT – PROPOSED TEST FIT

Private Offices	1	Conference Rooms	1
Benching	20	Café	1
Reception	1	Coat Room	1
		IT Room	1

---

**TOTAL HEADCOUNT**      **22**

AVAILABLE SEPTEMBER 2019

SUITE 901 – 3,573 RSF

